

**TRANSMITTAL OF SHOP DRAWINGS, EQUIPMENT DATA, MATERIAL SAMPLES, OR
MANUFACTURER'S CERTIFICATES OF COMPLIANCE**

(Read Instructions on the reverse side prior to initiating this form)

DATE:

2/26/2002

TRANSMITTAL NO.

241C

Section I REQUEST FOR APPROVAL OF THE FOLLOWING ITEMS (This section will be initiated by the contractor)

TO: USACE Neal Kolb 26 Rustic Mall Manville, NJ 08835	FROM: Sevenson Environmental Services, Inc. 2749 Lockport Rd. Niagara Falls, NY 14305	CONTRACT NO.: DACW41-01-D-0001 Del. Order # 0001	<input type="checkbox"/> This is a New Submittal <input checked="" type="checkbox"/> Resubmittal of Transmittal No: 241B Check One: This Transmittal is for <input type="checkbox"/> FIO <input checked="" type="checkbox"/> Gov't Approval
--	---	---	--

SPECIFICATION SEC. NO. (Cover only one section with each transmittal)
01550

PROJECT TITLE AND LOCATION:
Federal Creosote Superfund Site WAD 01 OU-1, Phase 1, WO 02 Manville, NJ

ITEM NO. a.	DESCRIPTION OF ITEMS SUBMITTED (Type, size, model number, etc.) b.	MFG. OR CONTR. CAT., CURVE DRAWING OR BROCHURE NO. (See Instruction No. 8) c.	NO. OF COPIES d.	CONTRACT REFERENCE DOCUMENT		For Contractor Use g.	VARIATIONS (See instruction No. 6) h.	FOR CE USE CODE i.
				SPEC. PARA. NO. e.	DRAWING SHEET NO. f.			
5	Revised As-Built Survey for 141 South Main St. - Daycare Center from Kennon Surveying Co.		6	1.2.5		A		A

REMARKS: Revised as per comments on Submittal #241B

3 copies for N. Kolb, USACE, Project Field Office, 26 Rustic Mall, Manville, NJ 08835
 1 copy for T. Daniels, USACE, K.C. District, 757 Federal Bldg., 601 E. 12th St., 6th Floor Room 632, Kansas City, MO 64106
 1 copy for E. Urbanik, USACE N. Resident Office, NY District, 214 State Highway 18 N, E. Brunswick, NJ 08816
 1 copy for R. Puvogel, USEPA Project Manager, Region 2, Project Field Office, 26 Rustic Mall, Manville, NJ 08835


c.c. - G., McDonald SES, J. Stark SES, L. Elia SES, A. LaGreca SES, K. Lickfield SES

I certify that the above submitted items have been reviewed in detail and are correct and in strict conformance with the Contract Drawings and Specifications except as otherwise stated.


Joel Czachorowski

NAME AND SIGNATURE OF CONTRACTOR

Section II APPROVAL ACTION

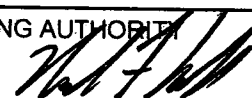INCLOSURES RETURNED (List by Item No.)	NAME, TITLE AND SIGNATURE OF APPROVING AUTHORITY NEAL F. KOLB, ALT C.O.R. 	DATE 27 FEB 2002
---	---	----------------------------




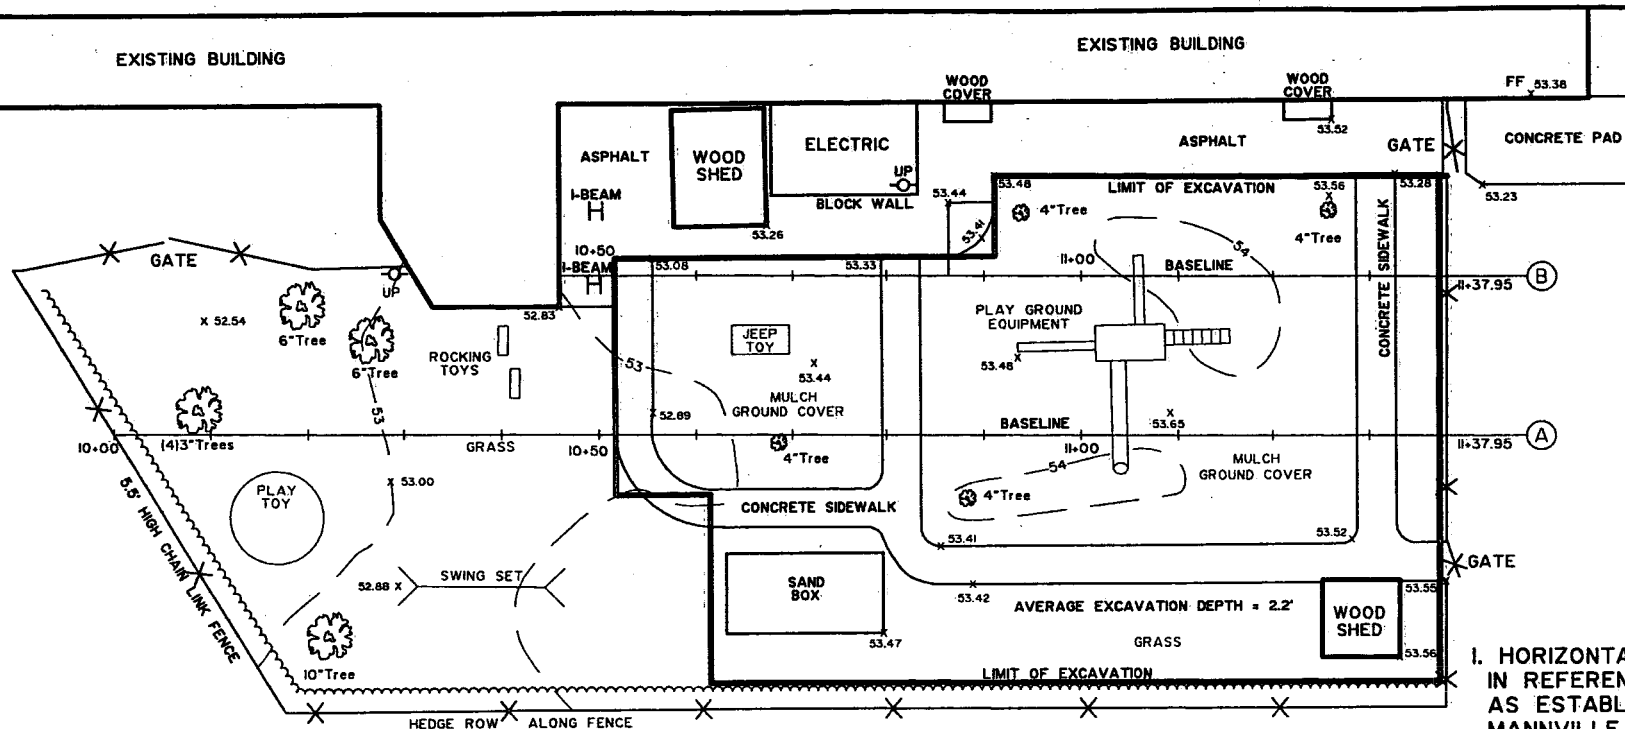

NOTES

1. HORIZONTAL AND VERTICAL ORIENTATION SHOWN HEREON IN REFERENCE TO N.J. STATE PLANE COORDINATE SYSTEM AS ESTABLISHED FOR FEDERAL CREOSOTE SUPERFUND SITE, MANNVILLE, NEW JERSEY.
2. ORIGINAL GROUND SHOWN IN PROFILE HEREON FROM FIELD SURVEY PERFORMED BY KENNON SURVEYING SERVICES PERSONNEL 7/25/01.
3. EXCAVATION SHOWN IN PROFILE HEREON FROM FIELD SURVEY PERFORMED BY KENNON SURVEYING SERVICES PERSONNEL 8-14-01.
4. AS-BUILT SHOWN IN PROFILE HEREON FROM FIELD SURVEY PERFORMED BY KENNON SURVEYING SERVICES PERSONNEL 9-05-01.

CORPS OF ENGINEERS
APPROVED
Subject to plans and specifications

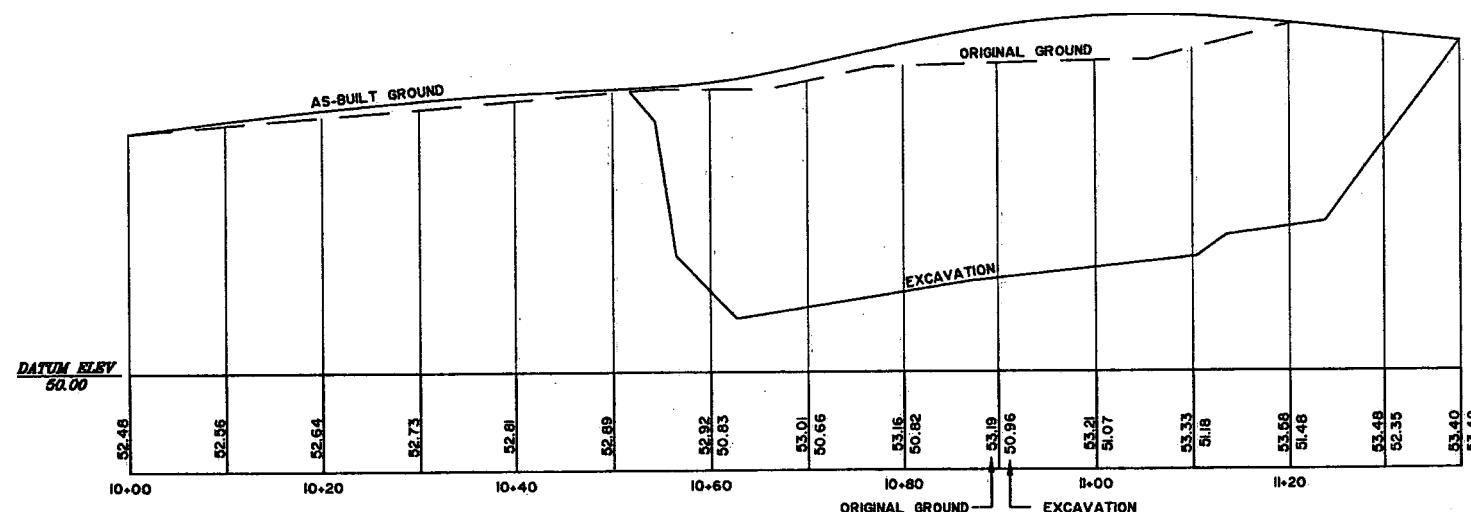

SECTION 'A'

PROFILE SCALE
HOR. = 1" = 20'
VERT. 1" = 2'

KENNY L. KENNON, P.L.S.

PROFESSIONAL LAND SURVEYOR LICENSE NO. 37195

DATE: 2-21-02

REV. 2-21-02 ADD SECTION 'B'
REV. 12-03-01 ADD FENCE GATES
REV. 10-03-01 ADD CONTOURS AND PROFILE.

AS-BUILT MAP

DAY CARE CENTER REMEDIATION
FEDERAL CREOSOTE SUPER FUND SITE
BOROUGH OF MANNVILLE, SOMERSET COUNTY, N.J.

KSS KENNON SURVEYING SERVICES INC.
5 POWDER HORN DRIVE, SUITE 8
P.O. BOX 4477
WARREN, NEW JERSEY 07059

PHONE 732-564-1818 FAX 732-564-9999

DATE 9/19/01 SCALE 1" = 20' PROJ. NO. 1349 SHEET 1 OF 2

